




**CITY OF KAWARTHA LAKES  
AS-BUILT LATERAL LOCATION SHEET**

Location: \_\_\_\_\_ Street: \_\_\_\_\_ House # : \_\_\_\_\_ Lot # : \_\_\_\_\_  
(Hamlet / Village)

Contract Number: \_\_\_\_\_ Drawing Number: \_\_\_\_\_

Inspector's Name: \_\_\_\_\_ Date: \_\_\_\_\_  
(Please Print)

**AS CONSTRUCTED SERVICE LOCATION**

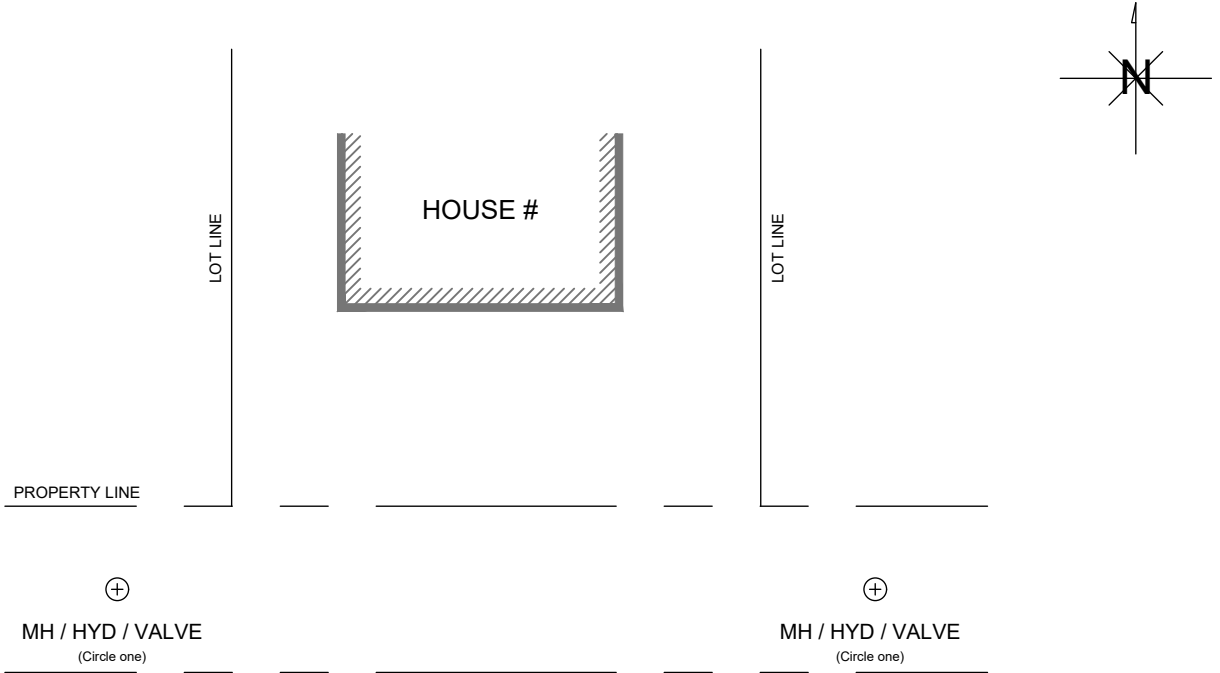

**INSTRUCTIONS:**

1. SKETCH SANITARY, STORM & WATER LATERAL LOCATIONS.
2. SERVICE MUST BE TIED DOWN TO AT LEAST ONE BUILDING CORNER AND ONE STRUCTURE (MH / HYD / VALVE).

**NOTE:**

THE LOCATION AND ELEVATION OF THE LATERAL AT THE PROPERTY LINE MUST BE CONFIRMED PRIOR TO INSTALLATION ON PRIVATE PROPERTY.

**SANITARY**

Length of Lateral: \_\_\_\_\_  
 Diameter of Lateral: \_\_\_\_\_  
 Material & Class of Lateral: \_\_\_\_\_  
 Invert Elevation @ P/L: \_\_\_\_\_  
 Ground Elevation @ P/L: \_\_\_\_\_  
 Diameter of Main Line Pipe: \_\_\_\_\_  
 Main Line Pipe Material: \_\_\_\_\_  
 Upstream Structure # : \_\_\_\_\_  
 Distance to Upstream Structure : \_\_\_\_\_  
 Downstream Structure # : \_\_\_\_\_  
 Distance to Downstream Structure: \_\_\_\_\_

**STORM**

Length of Lateral: \_\_\_\_\_  
 Diameter of Lateral: \_\_\_\_\_  
 Material & Class of Lateral: \_\_\_\_\_  
 Invert Elevation @ P/L: \_\_\_\_\_  
 Ground Elevation @ P/L: \_\_\_\_\_  
 Diameter of Main Line Pipe: \_\_\_\_\_  
 Main Line Pipe Material: \_\_\_\_\_  
 Upstream Structure # : \_\_\_\_\_  
 Distance to Upstream Structure : \_\_\_\_\_  
 Downstream Structure # : \_\_\_\_\_  
 Distance to Downstream Structure: \_\_\_\_\_

**WATER**

Length of Lateral: \_\_\_\_\_  
 Diameter of Lateral: \_\_\_\_\_  
 Material & Class of Lateral: \_\_\_\_\_  
 Approximate Depth @ P/L: \_\_\_\_\_  
 Diameter of Main Line Pipe: \_\_\_\_\_  
 Main Line Pipe Material: \_\_\_\_\_  
 Notes:  
 \_\_\_\_\_  
 \_\_\_\_\_  
 \_\_\_\_\_